


Post-Remedial Soil Sample Summary


Sample ID	Depth (ftbg)	PID (ppm)	EPH (ppm)
PR1	11.5-12.0	0	ND
PR2	11.5-12.0	0	ND
PR3	11.5-12.0	0	ND
PR4	7.5-8.0	0	ND
PR5	7.5-8.0	0	ND
PR6	7.5-8.0	0	ND
PR7	8.5-9.0	0	ND
PR8	9.0-9.5	0	ND
PR9	12.0-12.5	0	ND
PR10	12.0-12.5	0	ND
PR11	12.0-12.5	0	ND
PR12	8.0-8.5	0	ND
PR13	8.0-8.5	0	ND
PR14	8.0-8.5	0	ND

Notes:

1. ftbg = feet below grade
2. ppm = parts per million
3. PID = Photo Ionization Detector
4. EPH = Extractable Petroleum Hydrocarbon

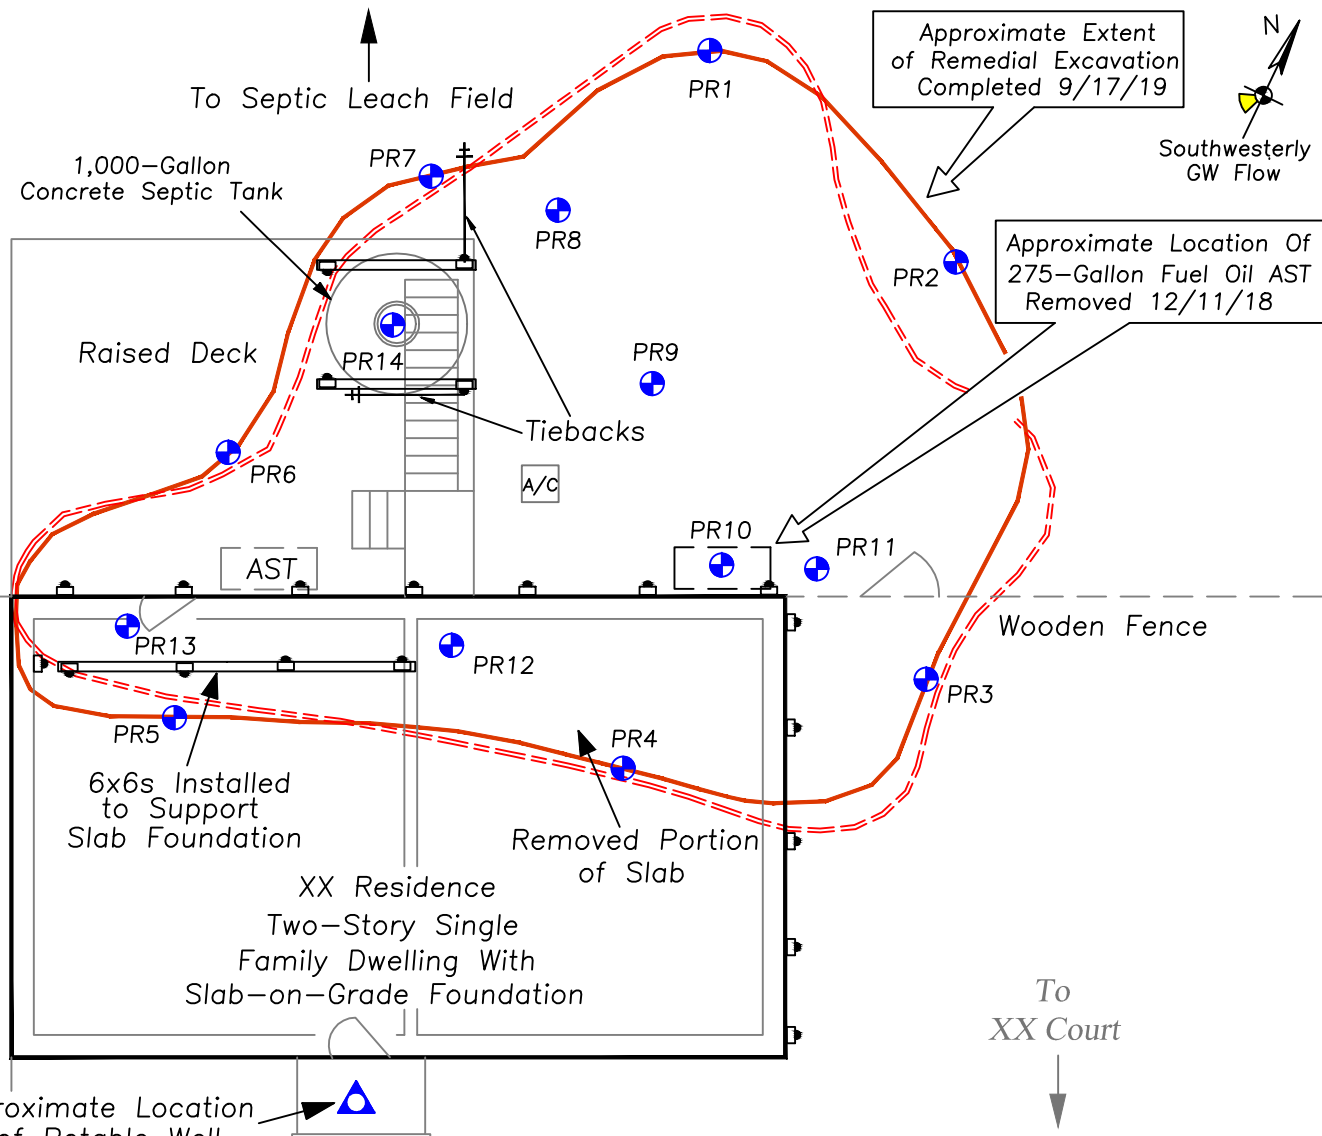

Scale: 1" = 10'

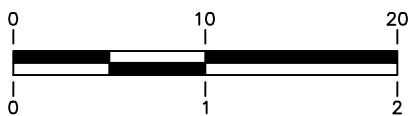

Legend

- ⊕ = Post-Remedial Soil Sample
- PR1 = Soil Sample ID
- = As-Built Foundation Pile
- = Post-Remedial GW Monitoring Well

Figure 4
Remedial Excavation

XX Property
XX
XX Twp., XX County, NJ
Block XX Lot XX

NJDEP Case No. XX-XX-XX-XXXX-XX



P.O. Box 229
Phoenixville, Pennsylvania 19460-0229
Tel(610)-935-3527 Fax(610)-935-9675